
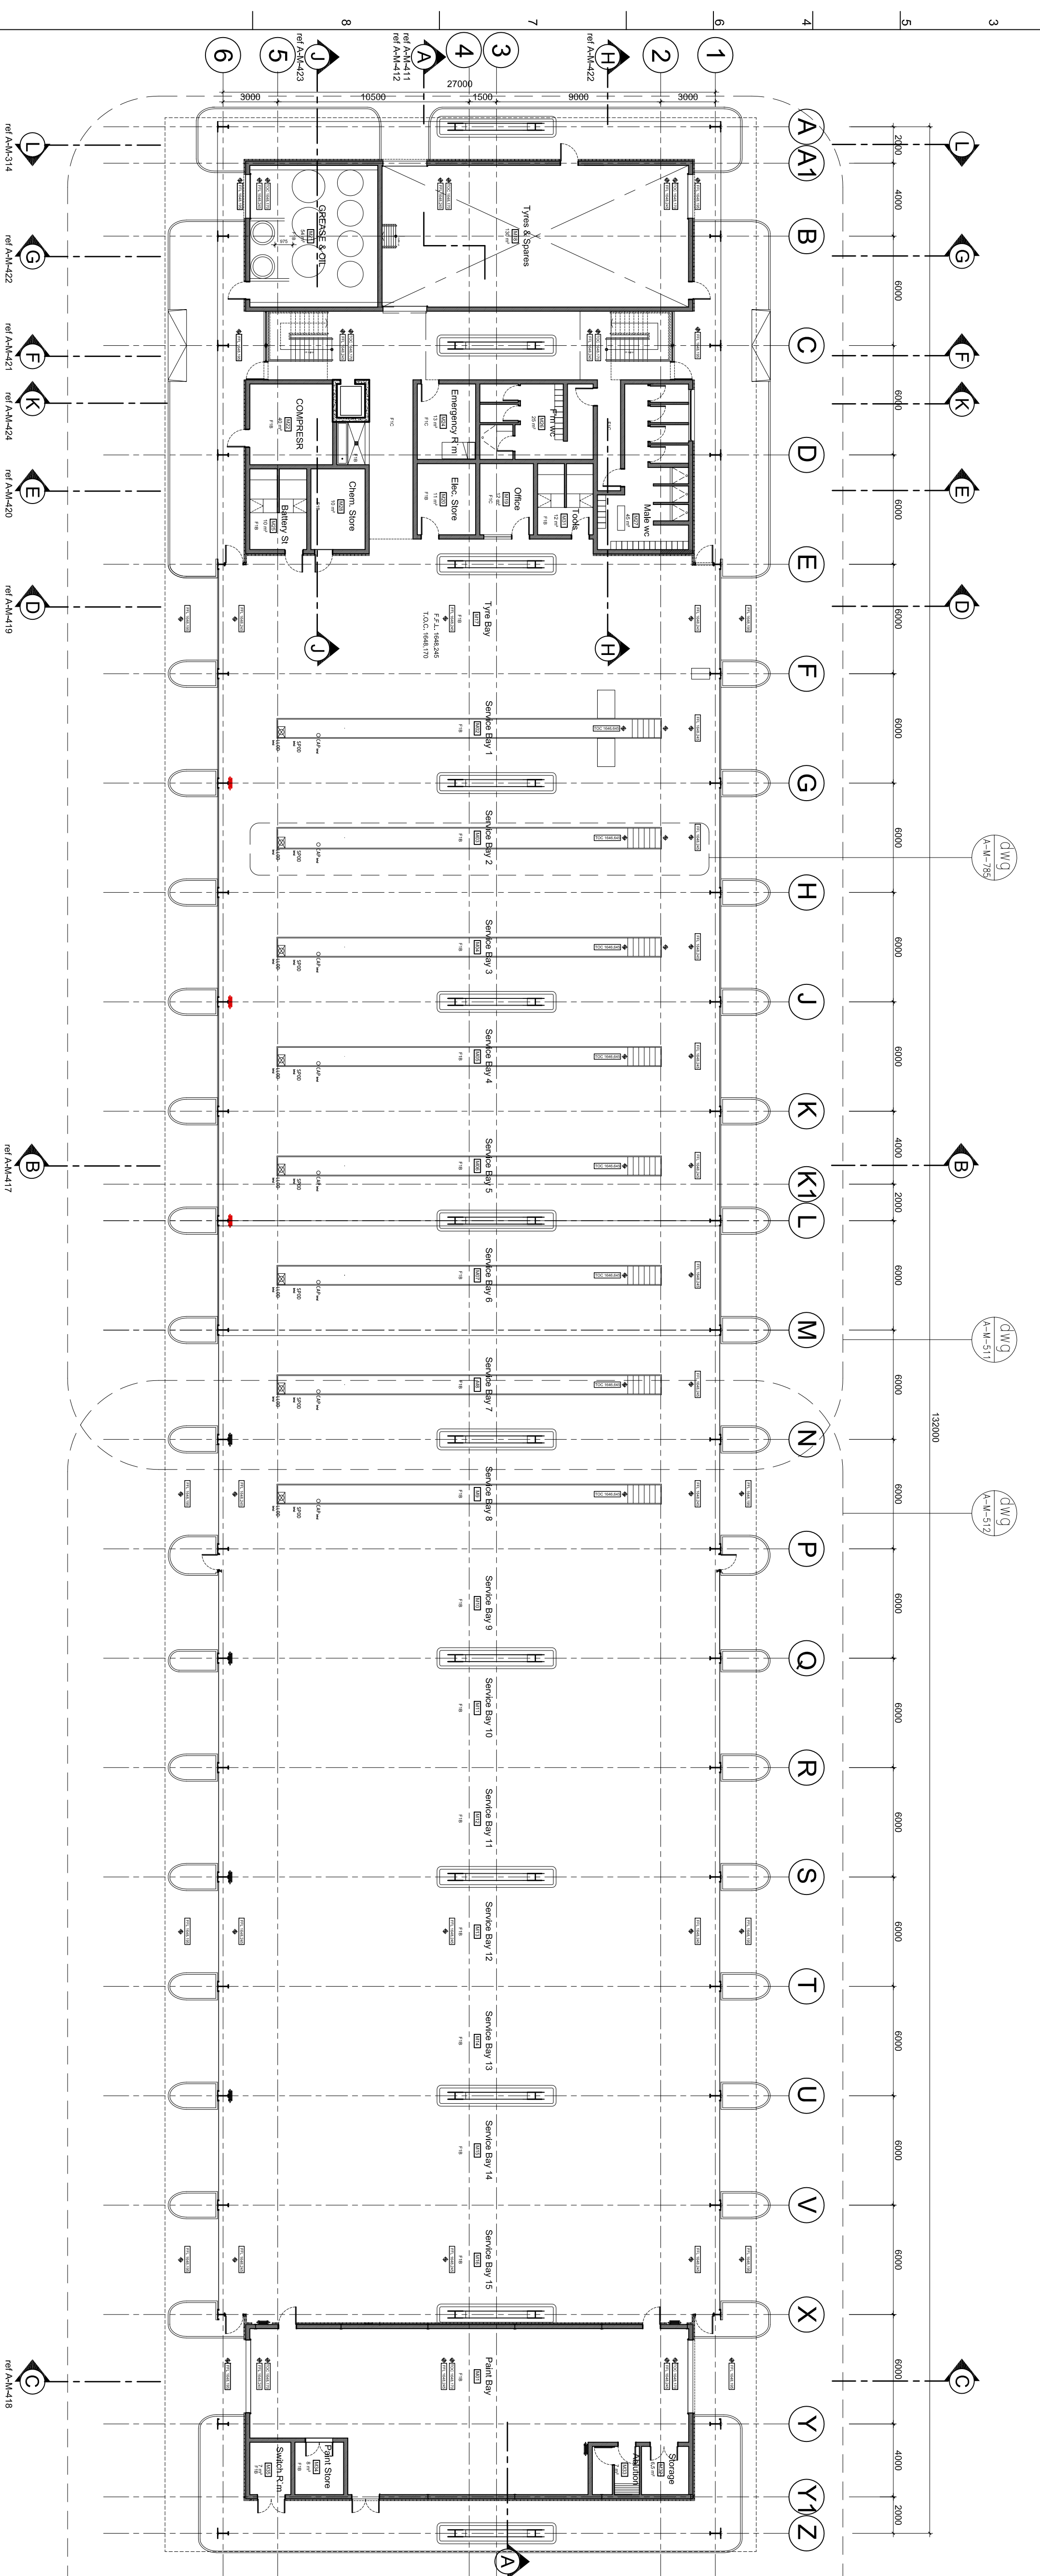


ALL DIMENSIONS AND LEVELS ARE TO BE VERIFIED ON SITE BY THE CONTRACTOR BEFORE COMMENCING ANY WORK.

This document and all the information herein remains the property of ARUP and may not be copied, reproduced or transmitted in part or in full without the written consent of ARUP. The information herein is provided for the specific project and circumstances other than those for which it was originally prepared and for which ARUP was commissioned, as defined on the document. Refer to the contract for all terms and conditions.

ARUP shall not be liable for the consequences of using this document other than for the purpose for which it was commissioned. Any user and any other person using or relying on the document for such other purpose, will be seen to use or rely on the document at their own risk and in accordance with the contract for design resulting here from.

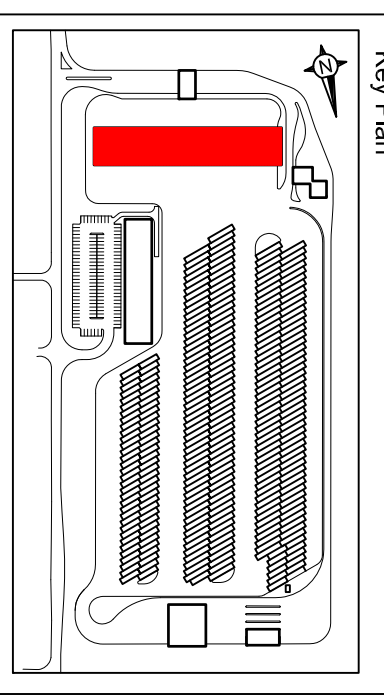

Ground Floor Plan

Scale 1:200 @ A1

Graphic & demarcation information ref
 A-A-780 A-A-781 A-A-782 A-A-783 A-A-784

Wall Finishes	Wall Finishes	Wall Finish Indicators - on plan	Ceiling Finishes	Screen Walls	Rainwater drainage systems	External Finishes
W1A. Paint on Plastered Brickwork W1B. Paint on Plastered Brickwork (wet areas) W1C. Plastic-elastic coating on Plastered Brickwork W1D. Semi Face Brickwork W2A. Stippled High-Build Epoxy W3A. Porcelain Tile W5A. Polycarbonate Multi Wall - Blockwork behind W5B. Polycarbonate Multi Wall - Ins. & Brickwork behind W5C. Plastic-elastic coating on Plastered Brickwork W6A. 6mm Polycarbonate Multi Wall Sun Screen Louvers W6B. Metal Louver - Eaves Administration Building W6C. Metal Louver - Screen W7A. Light steel part: metal sup. - 4hp x honeycomb pitch W7B. Acoustic partition W8A. Roll-Up Serrendia interlocking fixed panel W9A. Skimpster	W5H. Polycarbonate Multi Wall - Brickwork behind W5I. Polycarbonate Multi Wall - Ins. & Brickwork behind W5J. Polycarbonate Multi Wall - Colour W6A. 6mm Polycarbonate Multi Wall Sun Screen Louvers W6B. Metal Louver - Eaves Administration Building W6C. Metal Louver - Screen W7A. Light steel part: metal sup. - 4hp x honeycomb pitch W7B. Acoustic partition W8A. Roll-Up Serrendia interlocking fixed panel W9A. Skimpster	<ul style="list-style-type: none"> Below Level. under fit Low Level. fit to under side of sill Middle Level. sill to light shelf Both Levels. fit to light shelf 	C1A. Plasterboard Perimeter Ceiling C1B. Suspended Ceiling Panels (Wet areas) C1C. Suspended Ceiling Panels (Wet areas) C3A. Off-Shutter Concrete Soffit C3C. Painted Soffit C3D. Painted Soffit (wet areas) C4. Ceiling supported off ECO BEAM	S1A. Metal Screen S2A. Diamond mesh fencing Roof Finishes R1A. Metal Roofing R1B. Metal Roofing with Insulation Board R2A. Metal Roofing with Insulation Board R2B. Waterproofing R3A. Polycarbonate multi wall R4A. Bird Proofing R5A. Hall Guards	R1A. Floor Marking Paint R1B. Seamless Heavy-Duty Polyurethane Resin R1C. Seamless Medium-Duty Polyurethane Resin(REF) R1D. Seamless Medium-Duty Polyurethane Resin(REF) F2A. Carpet F3A. Timber Siding F3B. Coving F4A. Walk Off Mat	E1A. Powdercoated Concrete Balustrade B1. Perforated metal sheeting - 4hp x honeycomb pitch

Client
JDA

Job Title
REA VAYA Bus Depot
Dobsonville Main Depot
ERF 19/233-1Q & 20/233-1Q

Architects
ARUP
Interchange Design

10 Hill Street, Midrand Park, Johannesburg, Gauteng, South Africa
 Partner: Suite 33, Private Bag X1, Midrand, 2009
 Tel: +27 (0)11 741 2200
 Fax: +27 (0)11 741 2201
 www.arup.com

Maintenance Block
Ground Floor Plan
General Arrangements

Scale at A1: 1:200
 Plot ID:
 Drawing Status:
AS BUILT
 Job No: 181759.02
 Drawing No: A-M-211
 Issue: 1

© One Arup Partnership Ltd